


T08N-R02W-09_0000_MCS


Sec 9

Sec 9

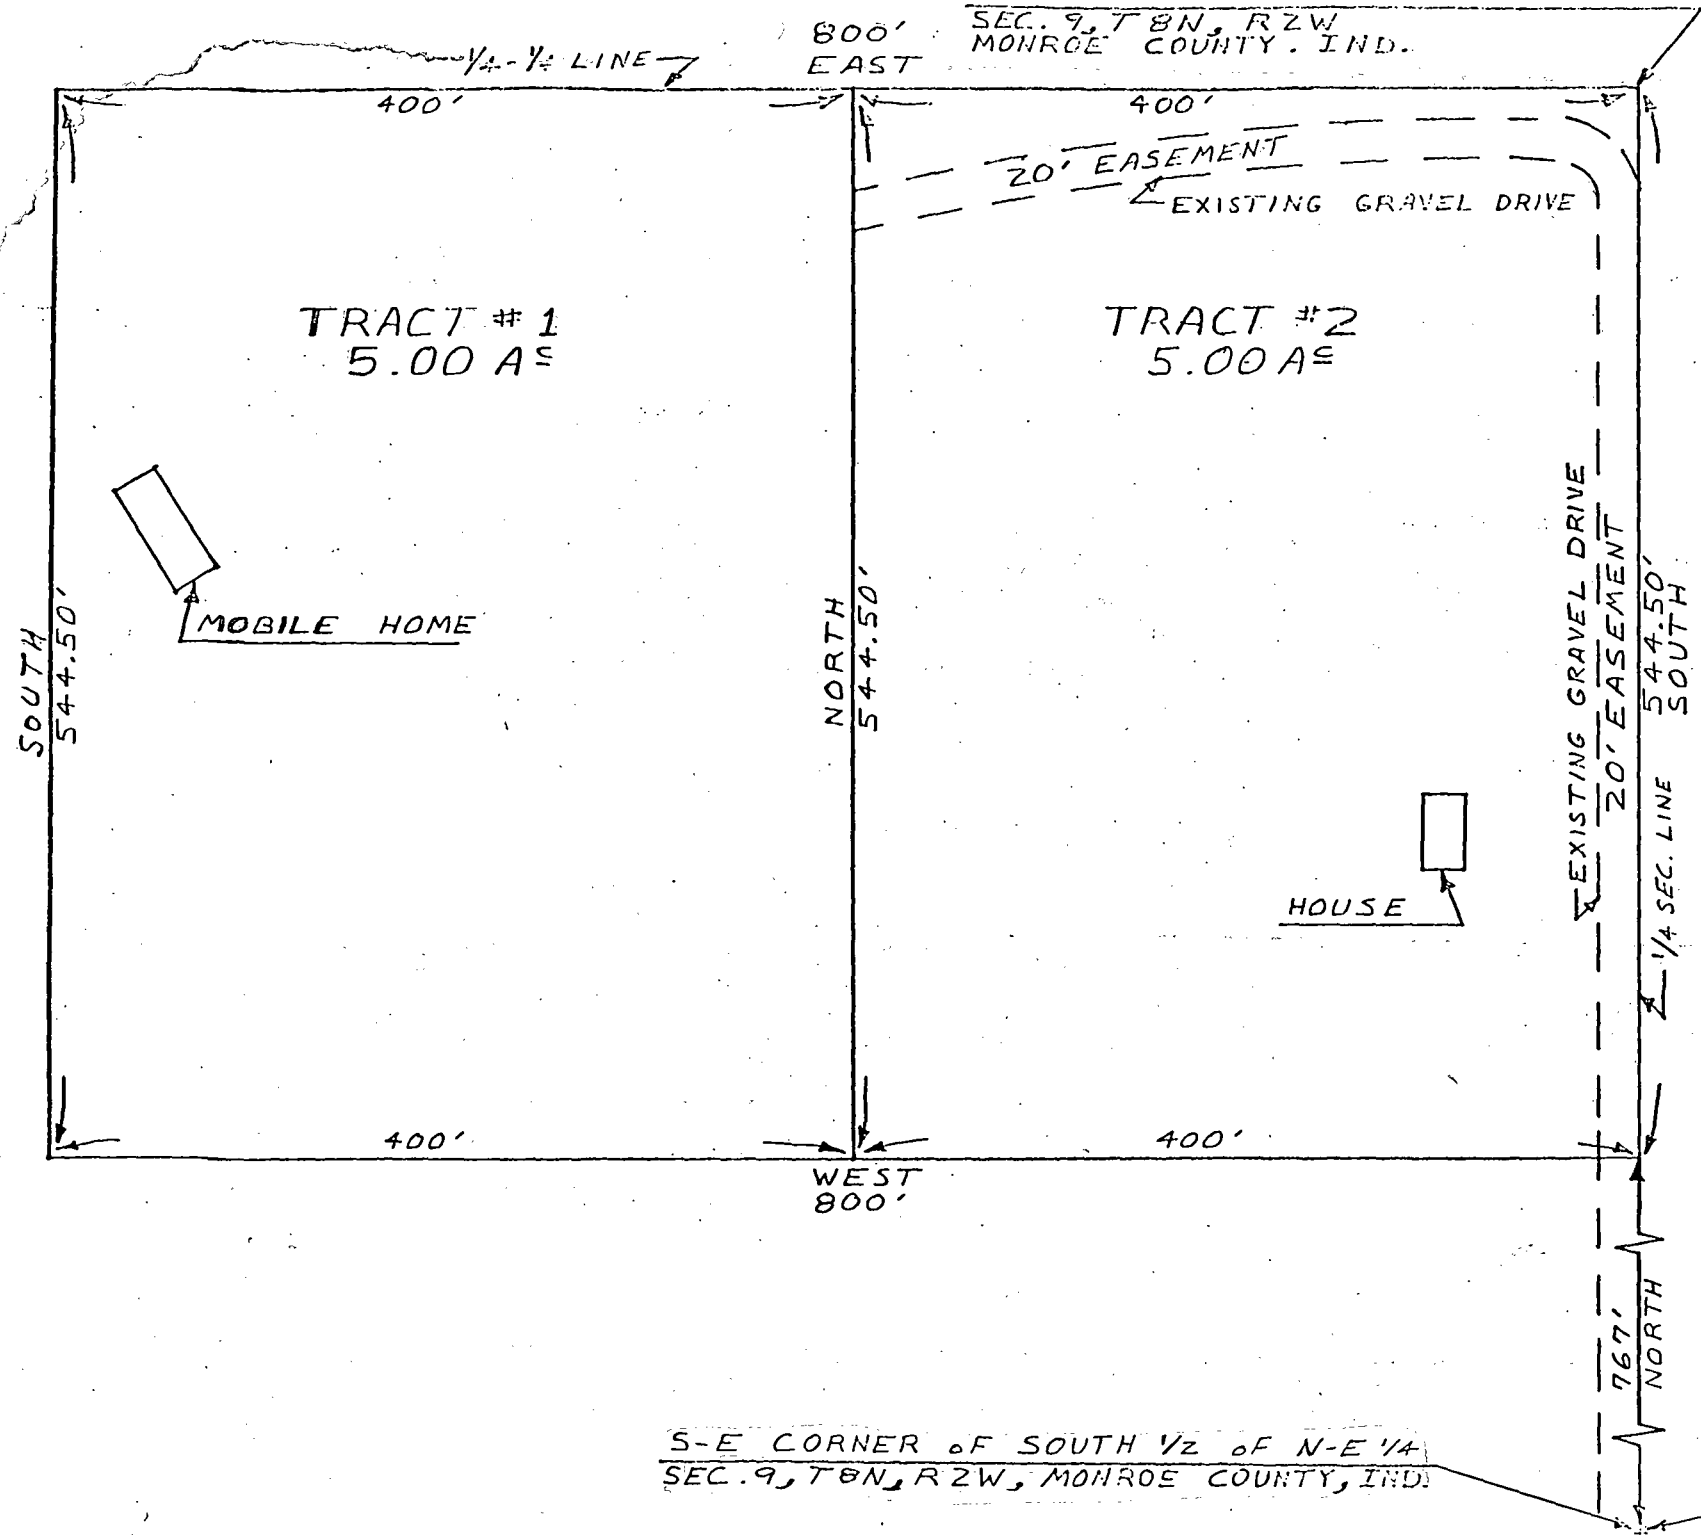

SCALE 1"=100'
FUNKHOUSER

Lee Utt
Lee Utt, R. L. S. # S0089, Indiana
1604 South Henderson St.
Bloomington, Indiana 47401
April 20, 1982

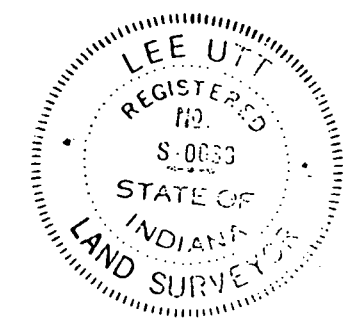

S-E CORNER OF SOUTH 1/2 OF N-E 1/4
SEC. 9, T8N, R2W, MONROE COUNTY, IND.

STONE & I.P.
Van Bu. M-07 Whitehall Quad

LEE UTT

REGISTERED LAND SURVEYOR NO. 50089, INDIANA

PHONE 332-6366

1604 SOUTH HENDERSON

BLOOMINGTON, INDIANA 47401


Legal description: Tract # 2


Jack Funkhouser

A part of the South one half of the Northeast quarter of Section 9, Township 8 North, Range 2 West, Monroe County, Indiana, bounded and described as follows:

Beginning at the Northeast corner of said South one half of the Northeast quarter; thence from said point of beginning and with the East line of said Northeast quarter and running South for 544.50 feet; thence leaving said East line and running West for 400 feet; thence North for 544.50 feet and to the North line of said South one half; thence East for 400 feet and to the point of beginning. Containing 5 acres, more or less.

Also, the right to use, and Subject to, that portion which lies within the boundary of the above described tract, a non-exclusive easement, Twenty (20) feet in width, said easement being described as follows: Beginning at the Southeast corner of said South one half of the Northeast quarter; thence running, to the West of, and with the East line of said Northeast quarter and with an existing gravel drive, North 1285 feet, more or less, thence following said existing gravel drive and running in a Southwesterly direction for 400 feet, more or less and to a point on the West line of the above described tract.

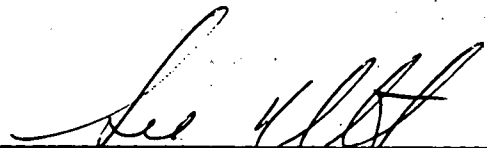
Lee Utt, R. L. S. # 50089, Indiana
April 20, 1982

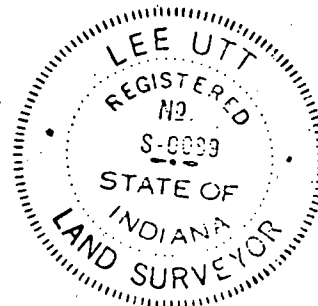


JULY 30, 1999

A PART OF
INDIANA, BO
NORTHWEST
688 FEET.
THE PLACE
CONTAINING


A PART OF
INDIANA, BE
BEGINNING
OF RICE R
THENCE NO
FEET; THEN
52.13 FEET
EAST 84.95
THENCE ALI
TAINING 3.0

A PART OF
INDIANA, BI
BEGINNING
OF RICE R
THENCE SC
FEET; THEN
178.34 FEI
ROAD; THE
CONTAINING

SUBJECT 1
A PART OF
INDIANA, B
BEGINNING
OF RICE F
THENCE S
FEET; THE

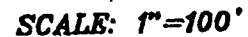

WILSON MINOR SUBDIVISION

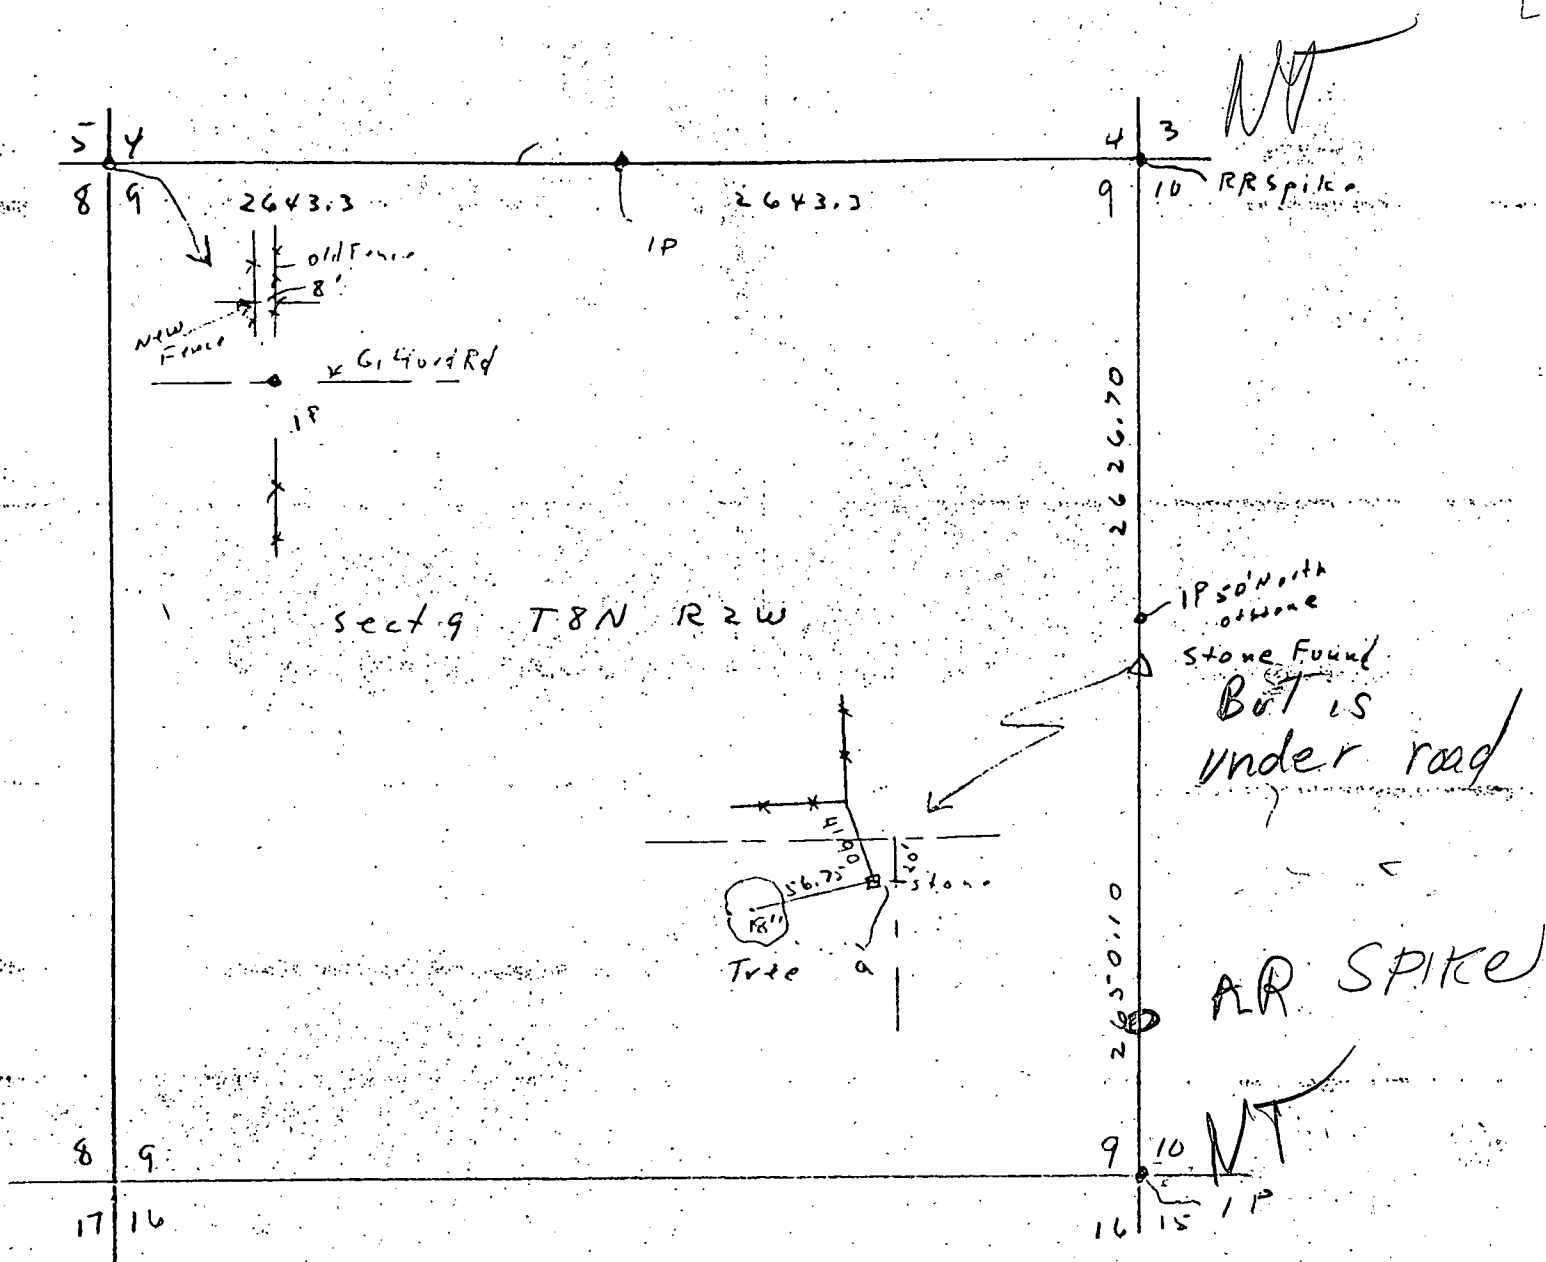

in Section 56 T 8 R 1 west as my deputy also in
 Section 8 T 7 R 2 W and all surveys made by him
 in said Sections ~~by him~~ is hereby sanctioned by
 me Geo. W. Cannon
 Surveyor of Monroe Co.

Surveyed for J. T. Rice and M. G. Morris
 North line of Section 9 T 8 N R 2 west
 on the 18th day of February 1879 James A. Sanders
 and James E. Bafford were sworn as Chain bearers
 and acted as such in the Survey. I traced the line
 East & West on the North of Sec 8 and Section 9
 also ~~the~~ surveyed the line from the west 1/4 mile cor
 of Section 9 North to the west 1/4 mile cor of Section 4
 The length of line on the west side of the N.W. 1/4
 of Sec 9 is 40.13 Chains and runs with a
 variation from the magnetic bearing ($3\frac{3}{4}^{\circ}$)
 Perpetuated the North west sec corner by planting
 a lime stone; witness taken Hickory 12 in diam
 $S 5\frac{1}{4}^{\circ} W - 125$ links B. Oak 9 in $N 55\frac{3}{4}^{\circ} E - 177$ links
 Parties both present and consenting
 February 21st 1879
 H. Henley
 Dep. M. C. Surveyor

Survey made for M. Mathers and ^{Comptroller}
 on the 20th February 1879 The parties being present
 and consenting: James Mathers and R. M. Denton
 being sworn and acting as Chain bearers.
 Surveyed and staked out the line dividing
 the east and west half of the North East
 quarter of Section 32 Town 8 N R 1 west
 The old corner stone at the South end of said
 line being found in the proper place
 Feb 21st 1879
 H. Henley
 Dep. M. C. Surveyor